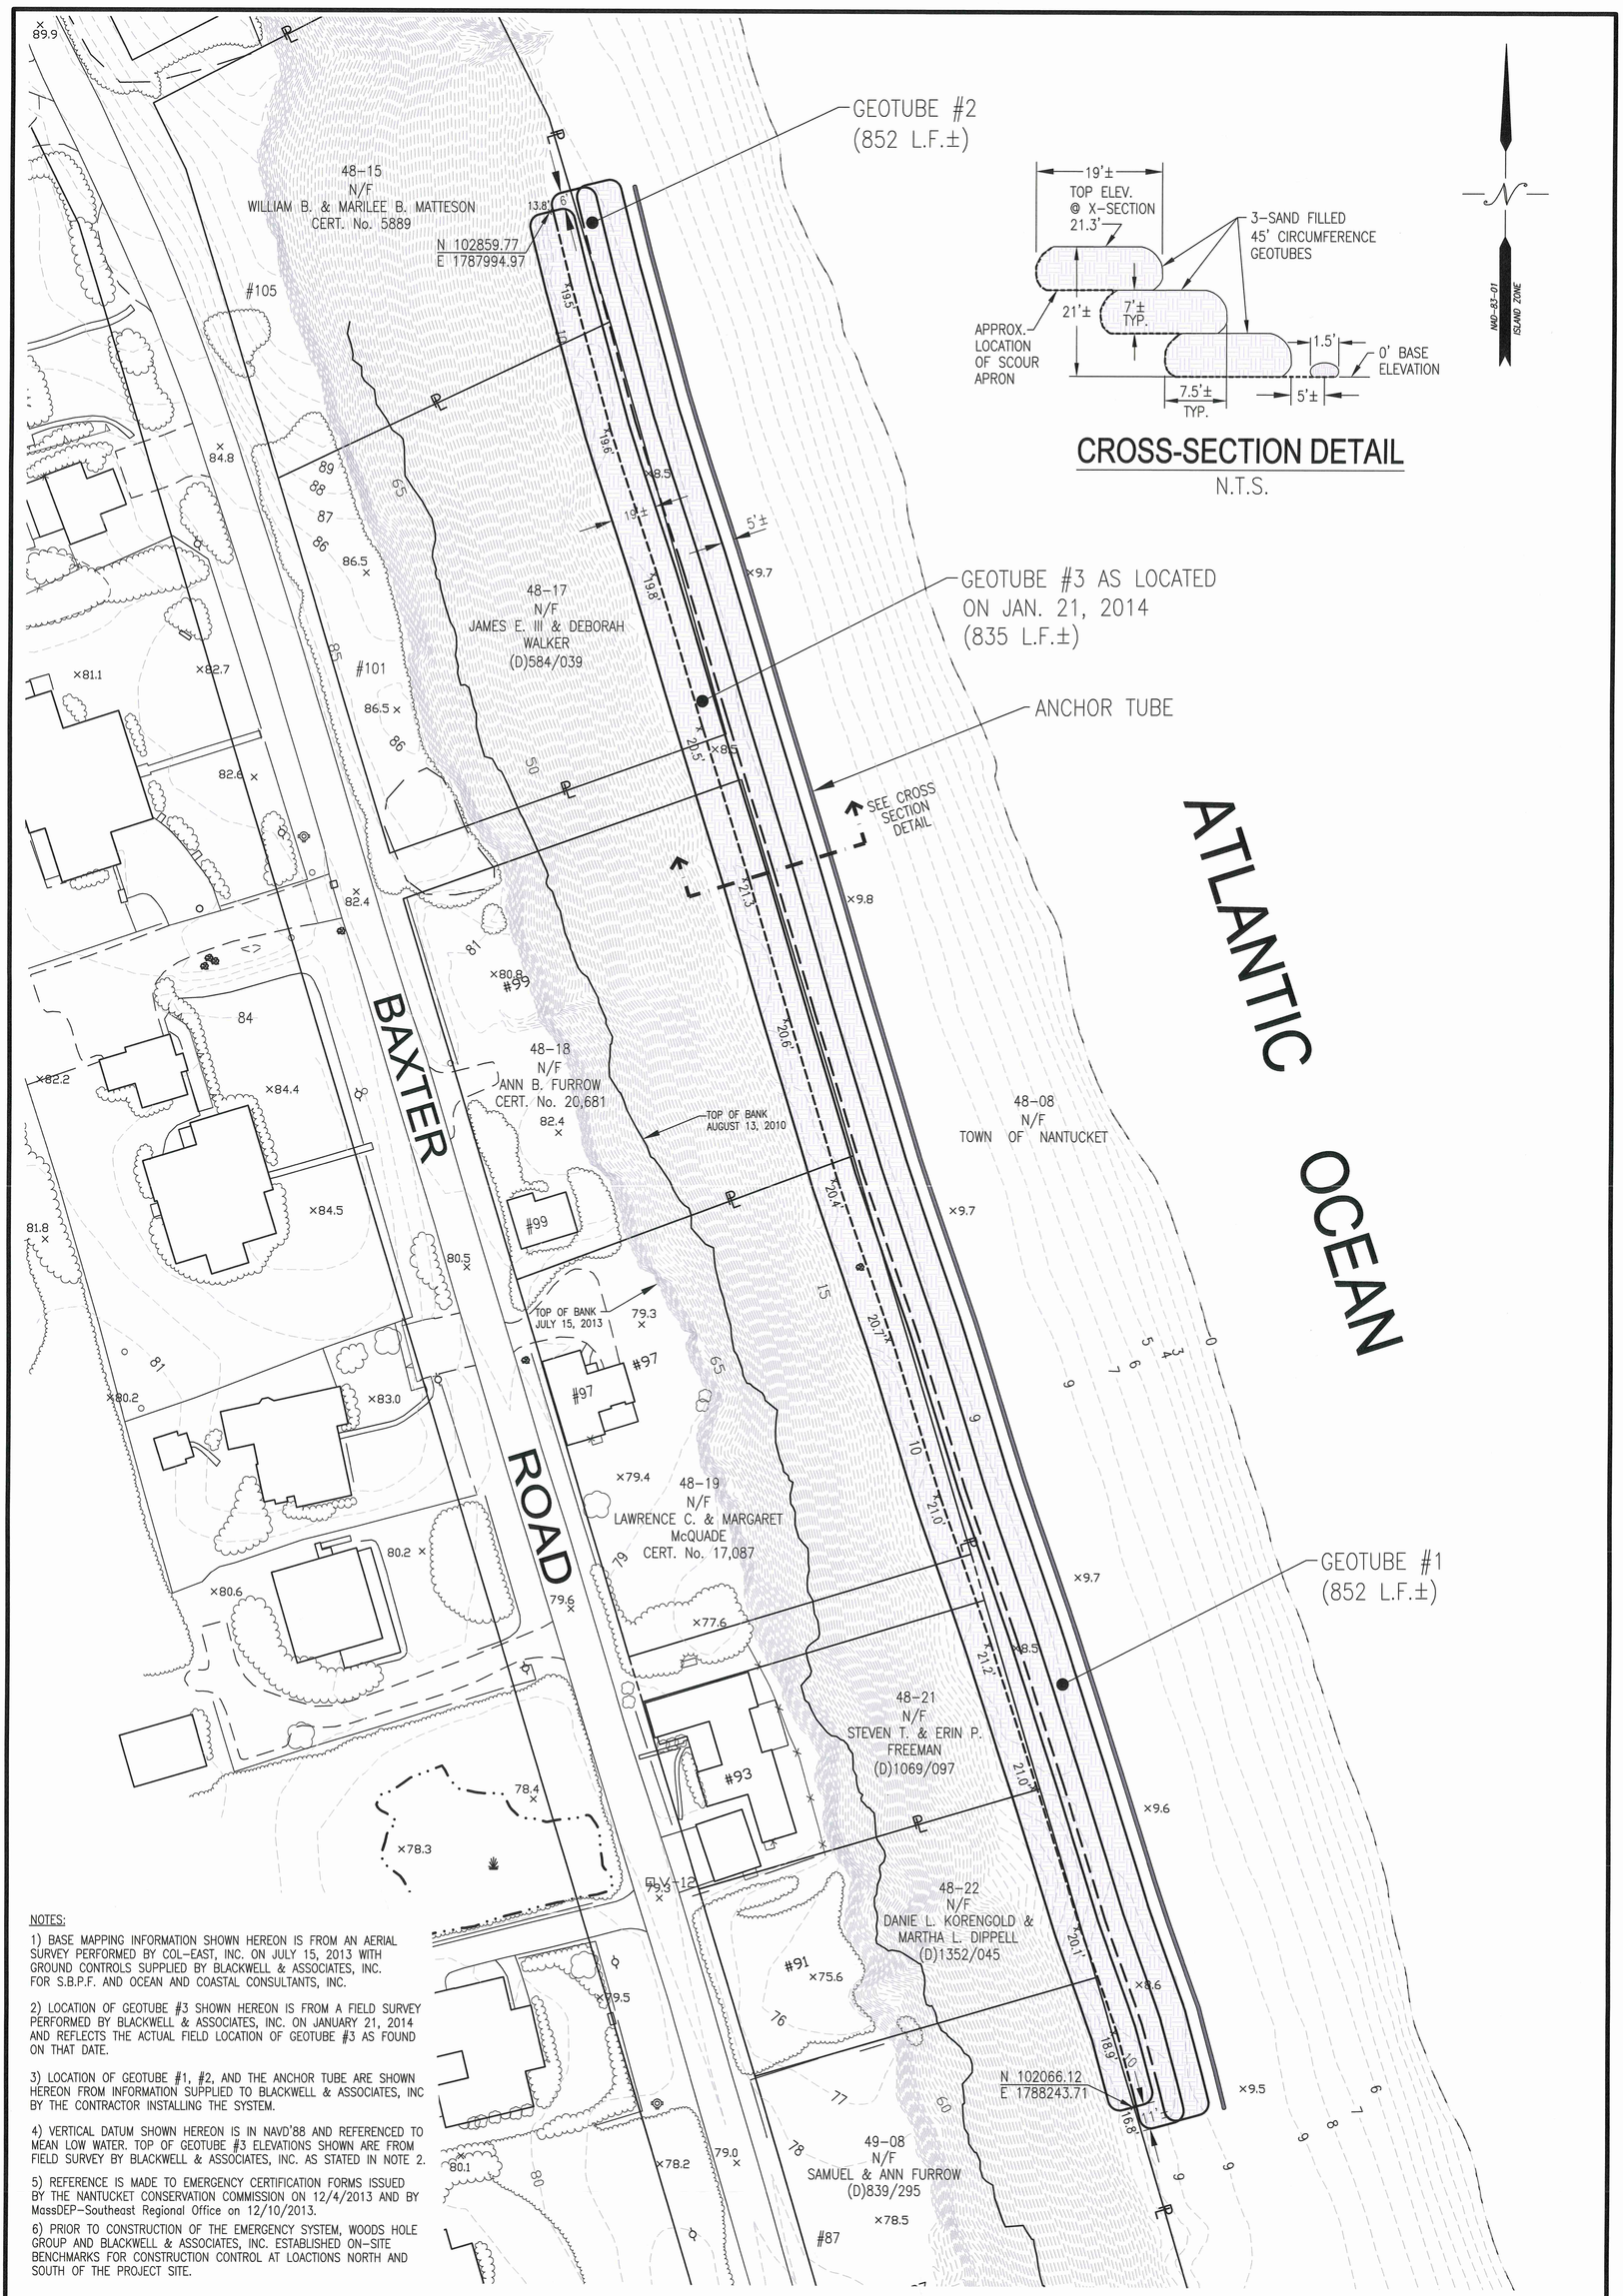

NOTES:

1) BASE MAPPING INFORMATION SHOWN HEREON IS FROM AN AERIAL SURVEY PERFORMED BY COL-EAST, INC. ON JULY 15, 2013 WITH GROUND CONTROLS SUPPLIED BY BLACKWELL & ASSOCIATES, INC. FOR S.B.P.F. AND OCEAN AND COASTAL CONSULTANTS, INC.

2) LOCATION OF GEOTUBE #3 SHOWN HEREON IS FROM A FIELD SURVEY PERFORMED BY BLACKWELL & ASSOCIATES, INC. ON JANUARY 21, 2014 AND REFLECTS THE ACTUAL FIELD LOCATION OF GEOTUBE #3 AS FOUND ON THAT DATE.

3) LOCATION OF GEOTUBE #1, #2, AND THE ANCHOR TUBE ARE SHOWN HEREON FROM INFORMATION SUPPLIED TO BLACKWELL & ASSOCIATES, INC BY THE CONTRACTOR INSTALLING THE SYSTEM.

4) VERTICAL DATUM SHOWN HEREON IS IN NAVD'88 AND REFERENCED TO MEAN LOW WATER. TOP OF GEOTUBE #3 ELEVATIONS SHOWN ARE FROM FIELD SURVEY BY BLACKWELL & ASSOCIATES, INC. AS STATED IN NOTE 2.

5) REFERENCE IS MADE TO EMERGENCY CERTIFICATION FORMS ISSUED BY THE NANTUCKET CONSERVATION COMMISSION ON 12/4/2013 AND BY MassDEP-Southeast Regional Office on 12/10/2013.

6) PRIOR TO CONSTRUCTION OF THE EMERGENCY SYSTEM, WOODS HOLE GROUP AND BLACKWELL & ASSOCIATES, INC. ESTABLISHED ON-SITE BENCHMARKS FOR CONSTRUCTION CONTROL AT LOACTIONS NORTH AND SOUTH OF THE PROJECT SITE.

V:\DRAWFILES\B7275\Col-East-2013\nantucket.dwg 1/27/2014 3:30:56 PM EST

NO.	DATE	DESCRIPTION	BY
1	1/30/14	PER COMMENTS / S. COHEN	LCA

COMMONWEALTH OF MASSACHUSETTS
LEO C. ASADOORIAN
No. 33910
PROFESSIONAL LAND SURVEYOR
1/30/14

BLACKWELL & ASSOCIATES, Inc.
PROFESSIONAL LAND SURVEYORS & CIVIL ENGINEERS
20 TEASDALE CIRCLE
NANTUCKET, MASSACHUSETTS 02554
(508) 228-9026
www.blackwellsurvey.com

RECORD DRAWING
EMERGENCY INSTALLATION of SAND FILLED GEOTUBES

PREPARED FOR: SIASCONSET BEACH PRESERVATION FUND
1 INCH = 30 FEET JANUARY 27, 2014

Design/Drawn by: L. ASADOORIAN
Approved by:

SHEET 1 OF 1 B-7275

V:\DRAWFILES\B7275\Col-East-2013\nantucket.dwg, ASBUILT-JAN2014, 1/30/2014 2:32:04 PM, Canon iPF700-24x36-P.pc3, 1:1